

STATE OF UTAH  
DEPARTMENT OF NATURAL RESOURCES  
DIVISION OF OIL, GAS AND MINING  
1594 West North Temple - Suite 1210  
Box 145801  
Salt Lake City, Utah 84114-5801  
Telephone: (801) 538-5291  
Fax: (801) 359-3940

LARGE MINING OPERATIONS 2007 PROGRESS REPORT  
January 1, 2007 to December 31, 2007

The information required in this form are based on provisions of the Mined Land Reclamation Act, Title 40-8, and the rules as under the Utah Minerals Regulatory Program.

1. Mine Permit Number: M037 012  
2. Mine Name: Pandora  
3. Name of Operator/Permittee: Demson Mines (USA) Corp.  
Note: If Operator's address, company representative or phone number have changed, please provide a replacement page to the Notice of Intention.

4. Mine Location: Section 1, T29S, R24E  
5. Report the gross amount of ore mined and waste moved, as well as the arrangement, positioning, or distribution of the material:

Gross Ore Mined 28,446 Tons, or \_\_\_\_\_ yd<sup>3</sup>  
Waste Material Moved 72,070 Tons, or \_\_\_\_\_ yd<sup>3</sup>  
New Disturbance 1.04 Acres during 2007  
Area Reclaimed 8 Acres during 2007  
Total Disturbed Area 16.04 Acres\*

Was the ore shipped off site? If not, where is the ore located? Ore was shipped to the White Mesa Mill, near Blanding, Utah  
Where is the waste located? In the permitted waste rock area at the Pandora Surface Facilities.

\*Total life of mine disturbance to the end of 2007.

6. Briefly describe the reclamation work performed during the past year. A map showing reclaimed areas and dates is suggested. (Submit form MR-SITE for an application for full or partial bond/site release).  
Areas around new vent hole (Pandora #7) was reclaimed by surface contouring, scarifying, and scattering brush.  
7. Include an updated map depicting surface disturbance and reclamation performed during the year, prepared in accordance with Rule R647-4-105.  
See attached.


I hereby certify, under penalties of law, the information provided in this report is true and correct to the best of my knowledge and belief.

Name (Typed or Print): Harold R. Roberts  
Title of Operator: Executive Vice President - US Operations  
Signature of Operator: Harold R. Roberts  
Date: January 21, 2008

Reviewed  
2/13/08  
[Signature]

RECEIVED  
JAN 30 2008  
DIV. OF OIL, GAS & MINING



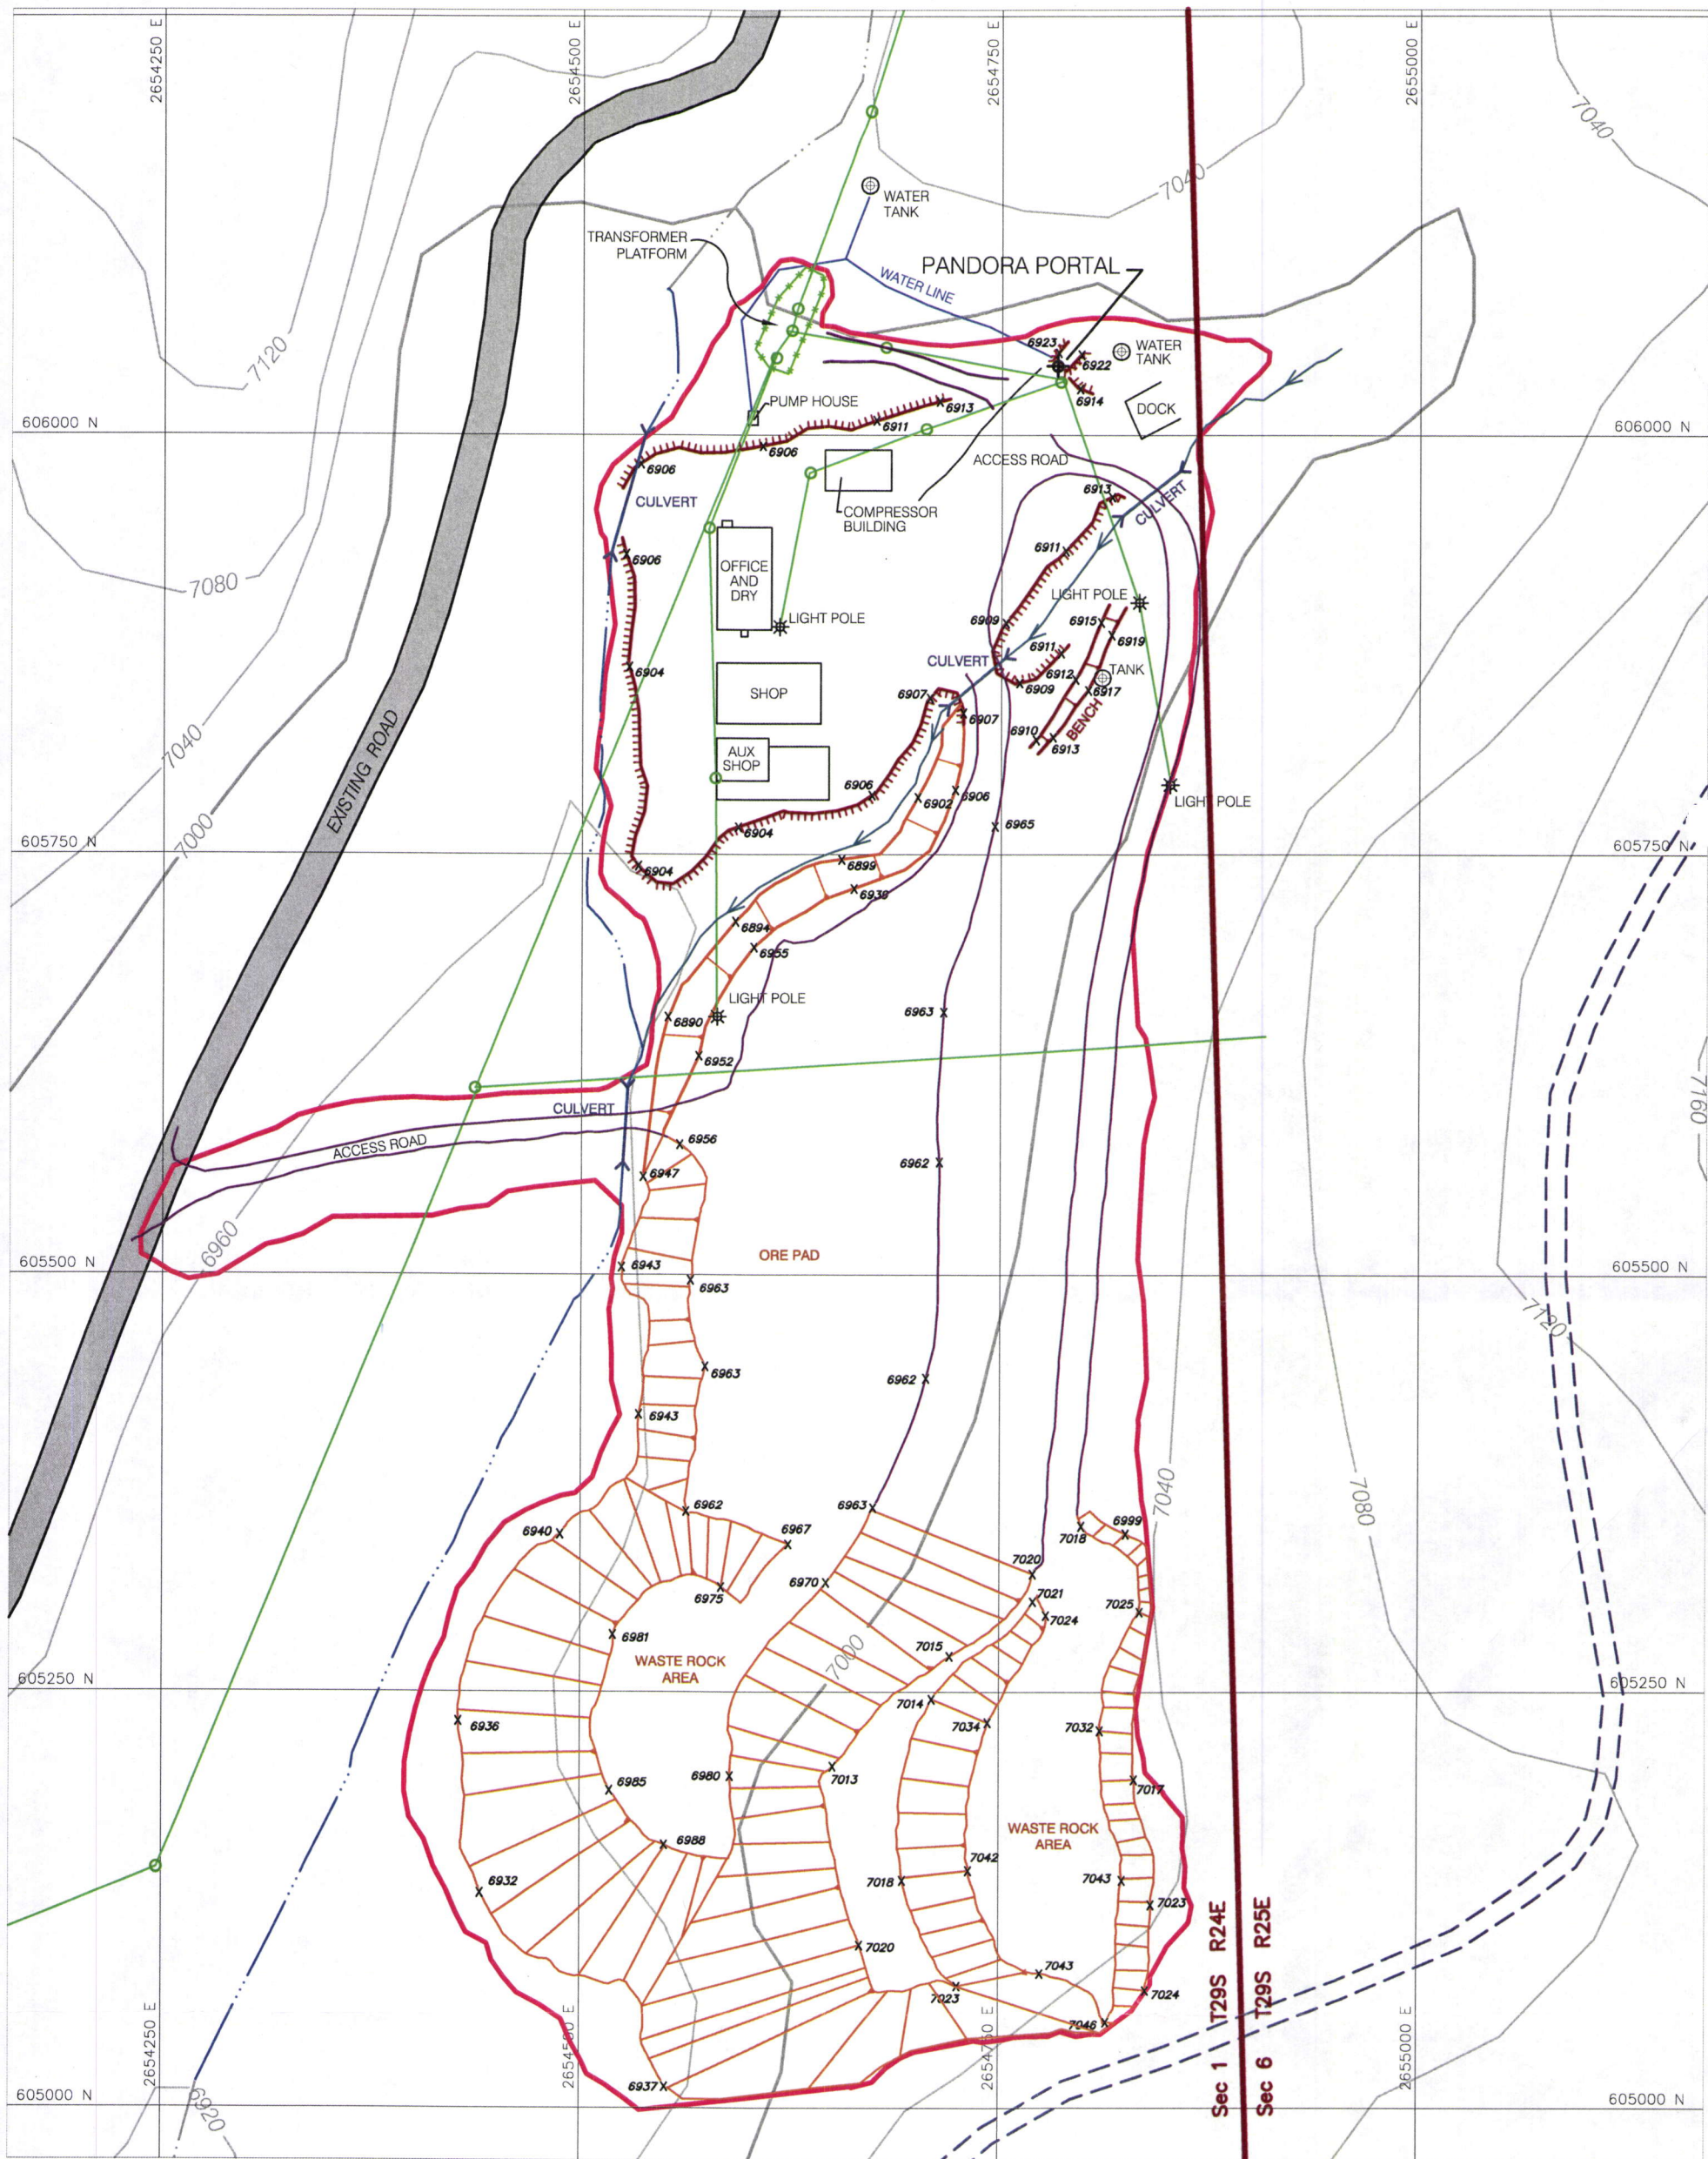

# LEGEND

- Access Roads/Surveyed
- Existing Permanent Roads (From USGS Topo)
- Existing Trails (From USGS Topo)
- Power Line and Pole
- Diversion Ditch or Channel
- Crest and Toe of Piles
- Berm
- Cribbing
- Disturbed Area

Disturbed Area = 387892 sqft. - 8.9 acres

RECEIVED

JAN 30 2008

DIV. OF OIL, GAS & MINING

Contour Interval = 40 Feet  
from USGS 7.5 minute Quadrangle sheet  
La Sal East, Utah  
Provisional Edition 1987



Utah State Plane Coordinate System  
South Zone, NAD 27

Project		LA SAL MINES	
REVISIONS	County: San Juan	State: Utah	
Date	By	Location: Sect 1, R 24 E Sect 6, R 25 E, T 29 S	
7/29/03	DLS	FIGURE 2-2 PANDORA MINE PERMIT M/037/012	
1/15/08	DMF		
Scale: 1"=100'		Date: April 10, 2003	lasal-100_pandora
Author: T. Wetz		Drafted By: D. L. Sledd	